Kukui'ula
SOUTH SHORE, KAUA'I

AS-BUILT CERTIFICATION

Member Name: _____

Parcel:_____ **Lot**:_____ **TMK No.:**_____

Neighborhood:_____

Surveyor or Civil Engineer: _____ Submittal Date: _____

Attached is certified documentation indicating the as-built location of the Improvements per the approved civil drawings with any discrepancies noted in red.

I, _____, hereby certify that the as-built locations of the Improvements are accurately indicated on the attached.

_____

Seal, Signature, and Date

Sample of As-Built Improvement Documentation

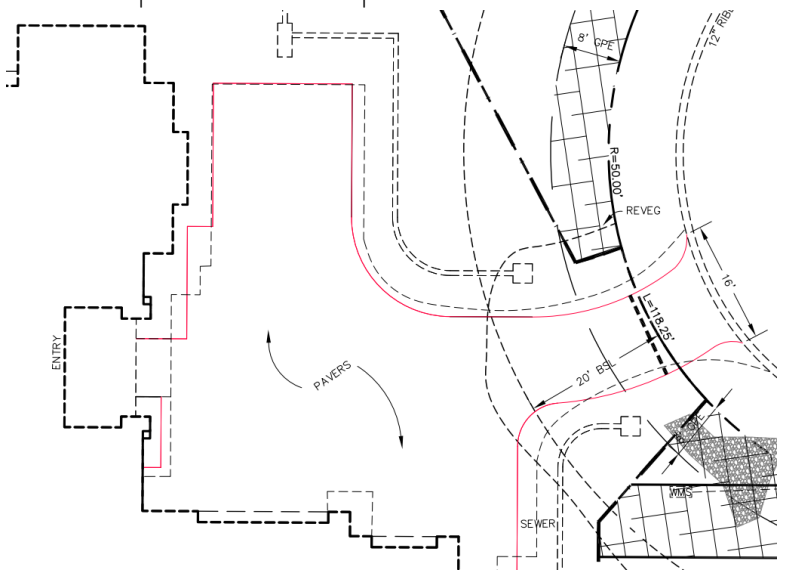

Improvements per Approved Civil Site Plan *As-Built Improvements*